




EXIST. FIRST FLOOR PLAN
SCALE: 1/4" = 1'-0"

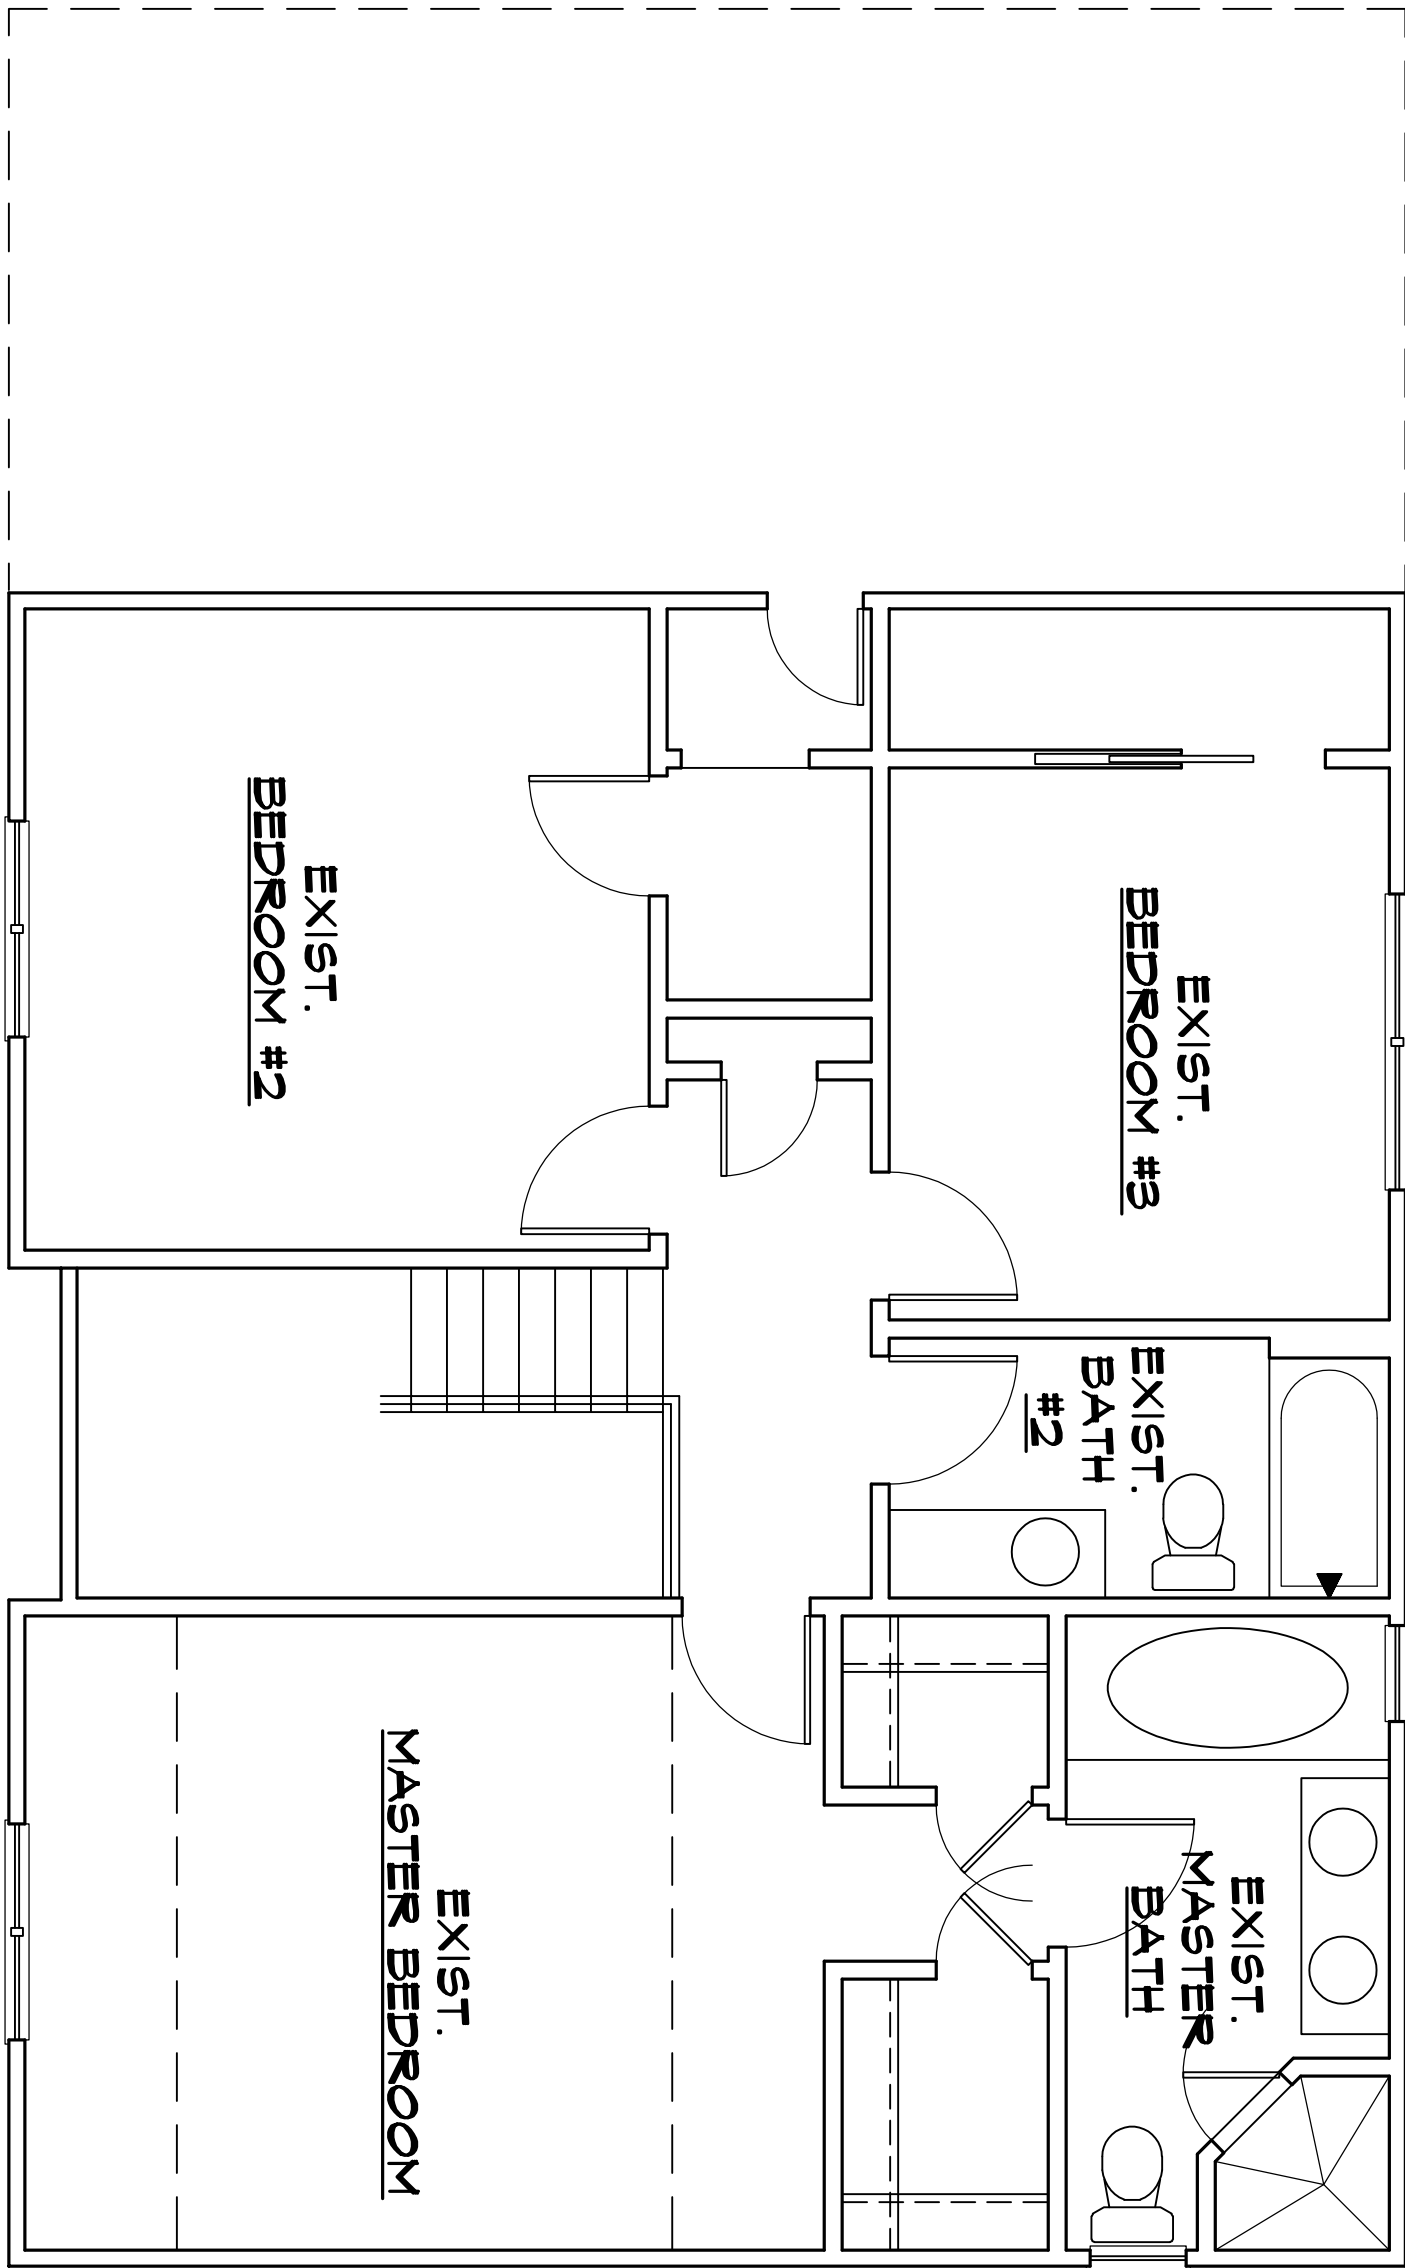

EXIST. SECOND FLOOR PLAN
SCALE: 1/4" = 1'-0"

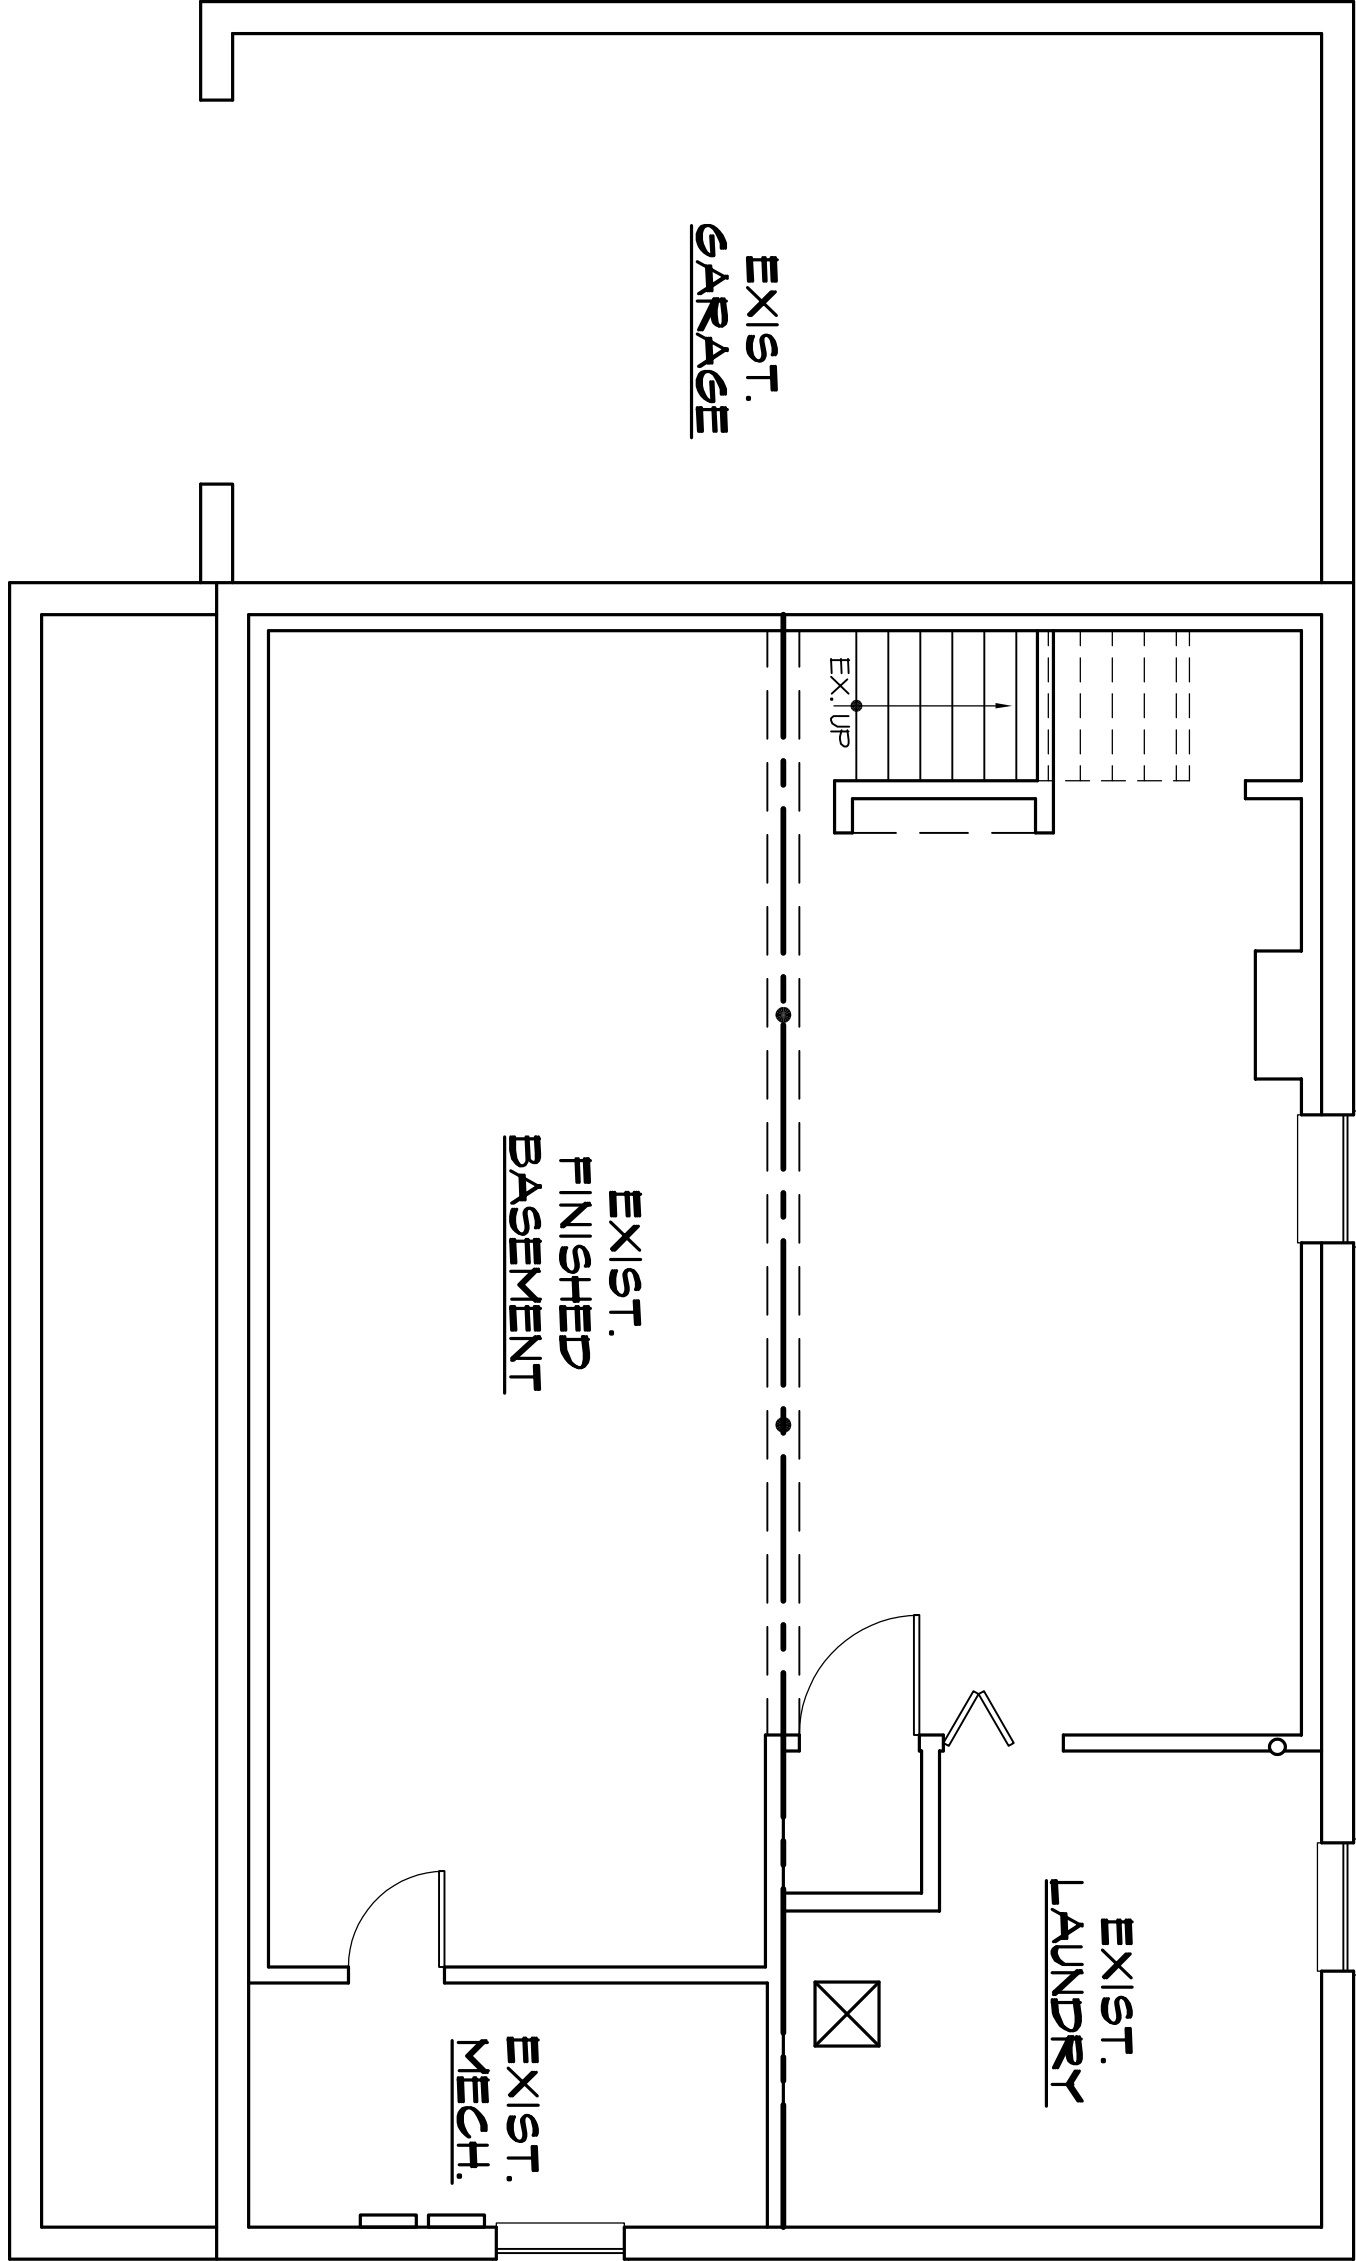

EXIST. BASEMENT PLAN
SCALE: 1/4" = 1'-0"

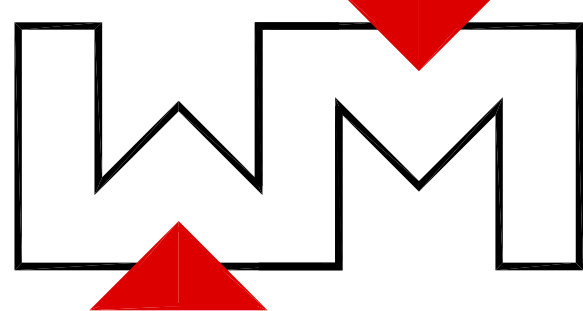

weltz | molinari
ARCHITECTURE
128 Broad St., 2nd Fl., Suite B, Red Bank, NJ 07701
t. 732.889.8000
email: info@wm-arch.com

PROPOSED ALTERATIONS / ADDITION FOR:

MR. & MRS. KOLLANDER

1102 KORFITSSEN ROAD
NEW MILFORD, NEW JERSEY

LOT: 3
BLOCK: 205

AS-BUILT PLANS

COMM. NO.: 20022


DRAWN BY: JLM
CHECKED BY: JAM
REVISED:

ISSUED FOR
ZONING BOARD


DATE: 05.12.21

AB1.01


ALL DRAWINGS AND WRITTEN MATERIALS APPEARING
HEREIN ARE THE PROPERTY OF WELTZ | MOLINARI
ARCHITECTURE. NO PART OF THIS DRAWING OR
ANY INFORMATION CONTAINED HEREIN MAY BE
REPRODUCED OR TRANSMITTED IN ANY FORM
OR BY ANY MEANS, ELECTRONIC OR MECHANICAL,
INCLUDING PHOTOCOPYING, RECORDING, OR BY
ANY INFORMATION STORAGE AND RETRIEVAL
SYSTEM, WITHOUT PERMISSION IN WRITING FROM
WELTZ | MOLINARI ARCHITECTURE. THE
DRAWING FOR THE PURPOSE OF COPYING THIS WORK
OR REVISING SAID DRAWING SHALL BE CONSIDERED A
VIOLATION OF THE ARCHITECT'S PROFESSIONAL
ETHICS AND A THEFT OF COMPANY ASSETS, BOTH OF
WHICH SHALL BE PERSECUTED TO THE FULLEST EXTENT
OF CURRENT STATUTES.

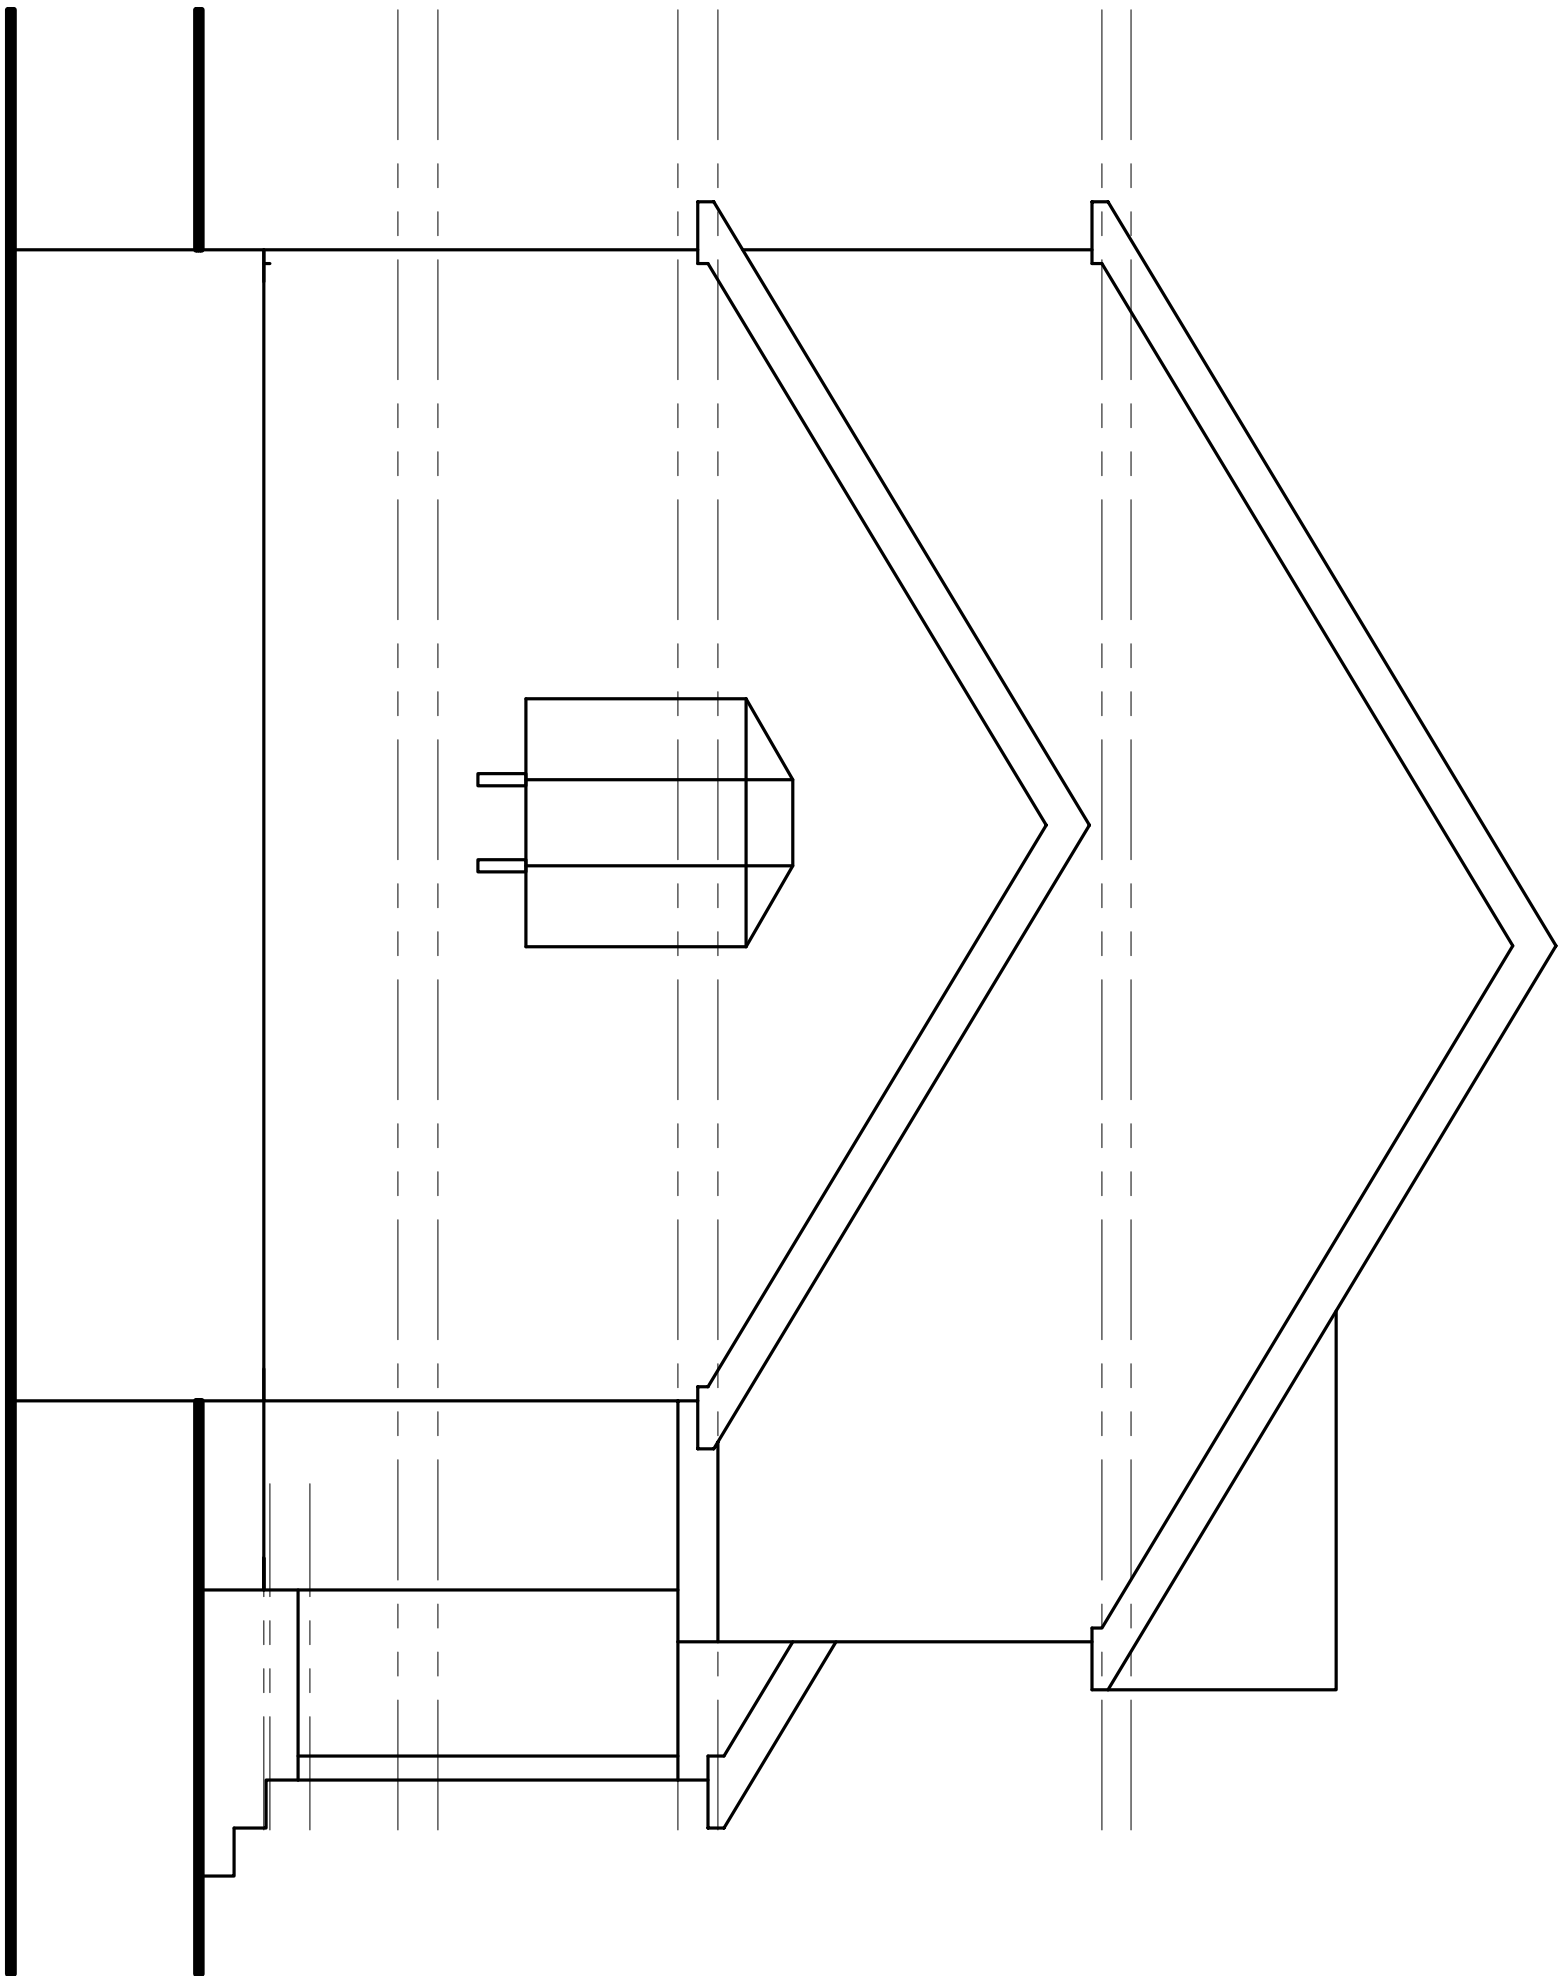


LEFT ELEVATION
SCALE: 1/4" = 1'-0"

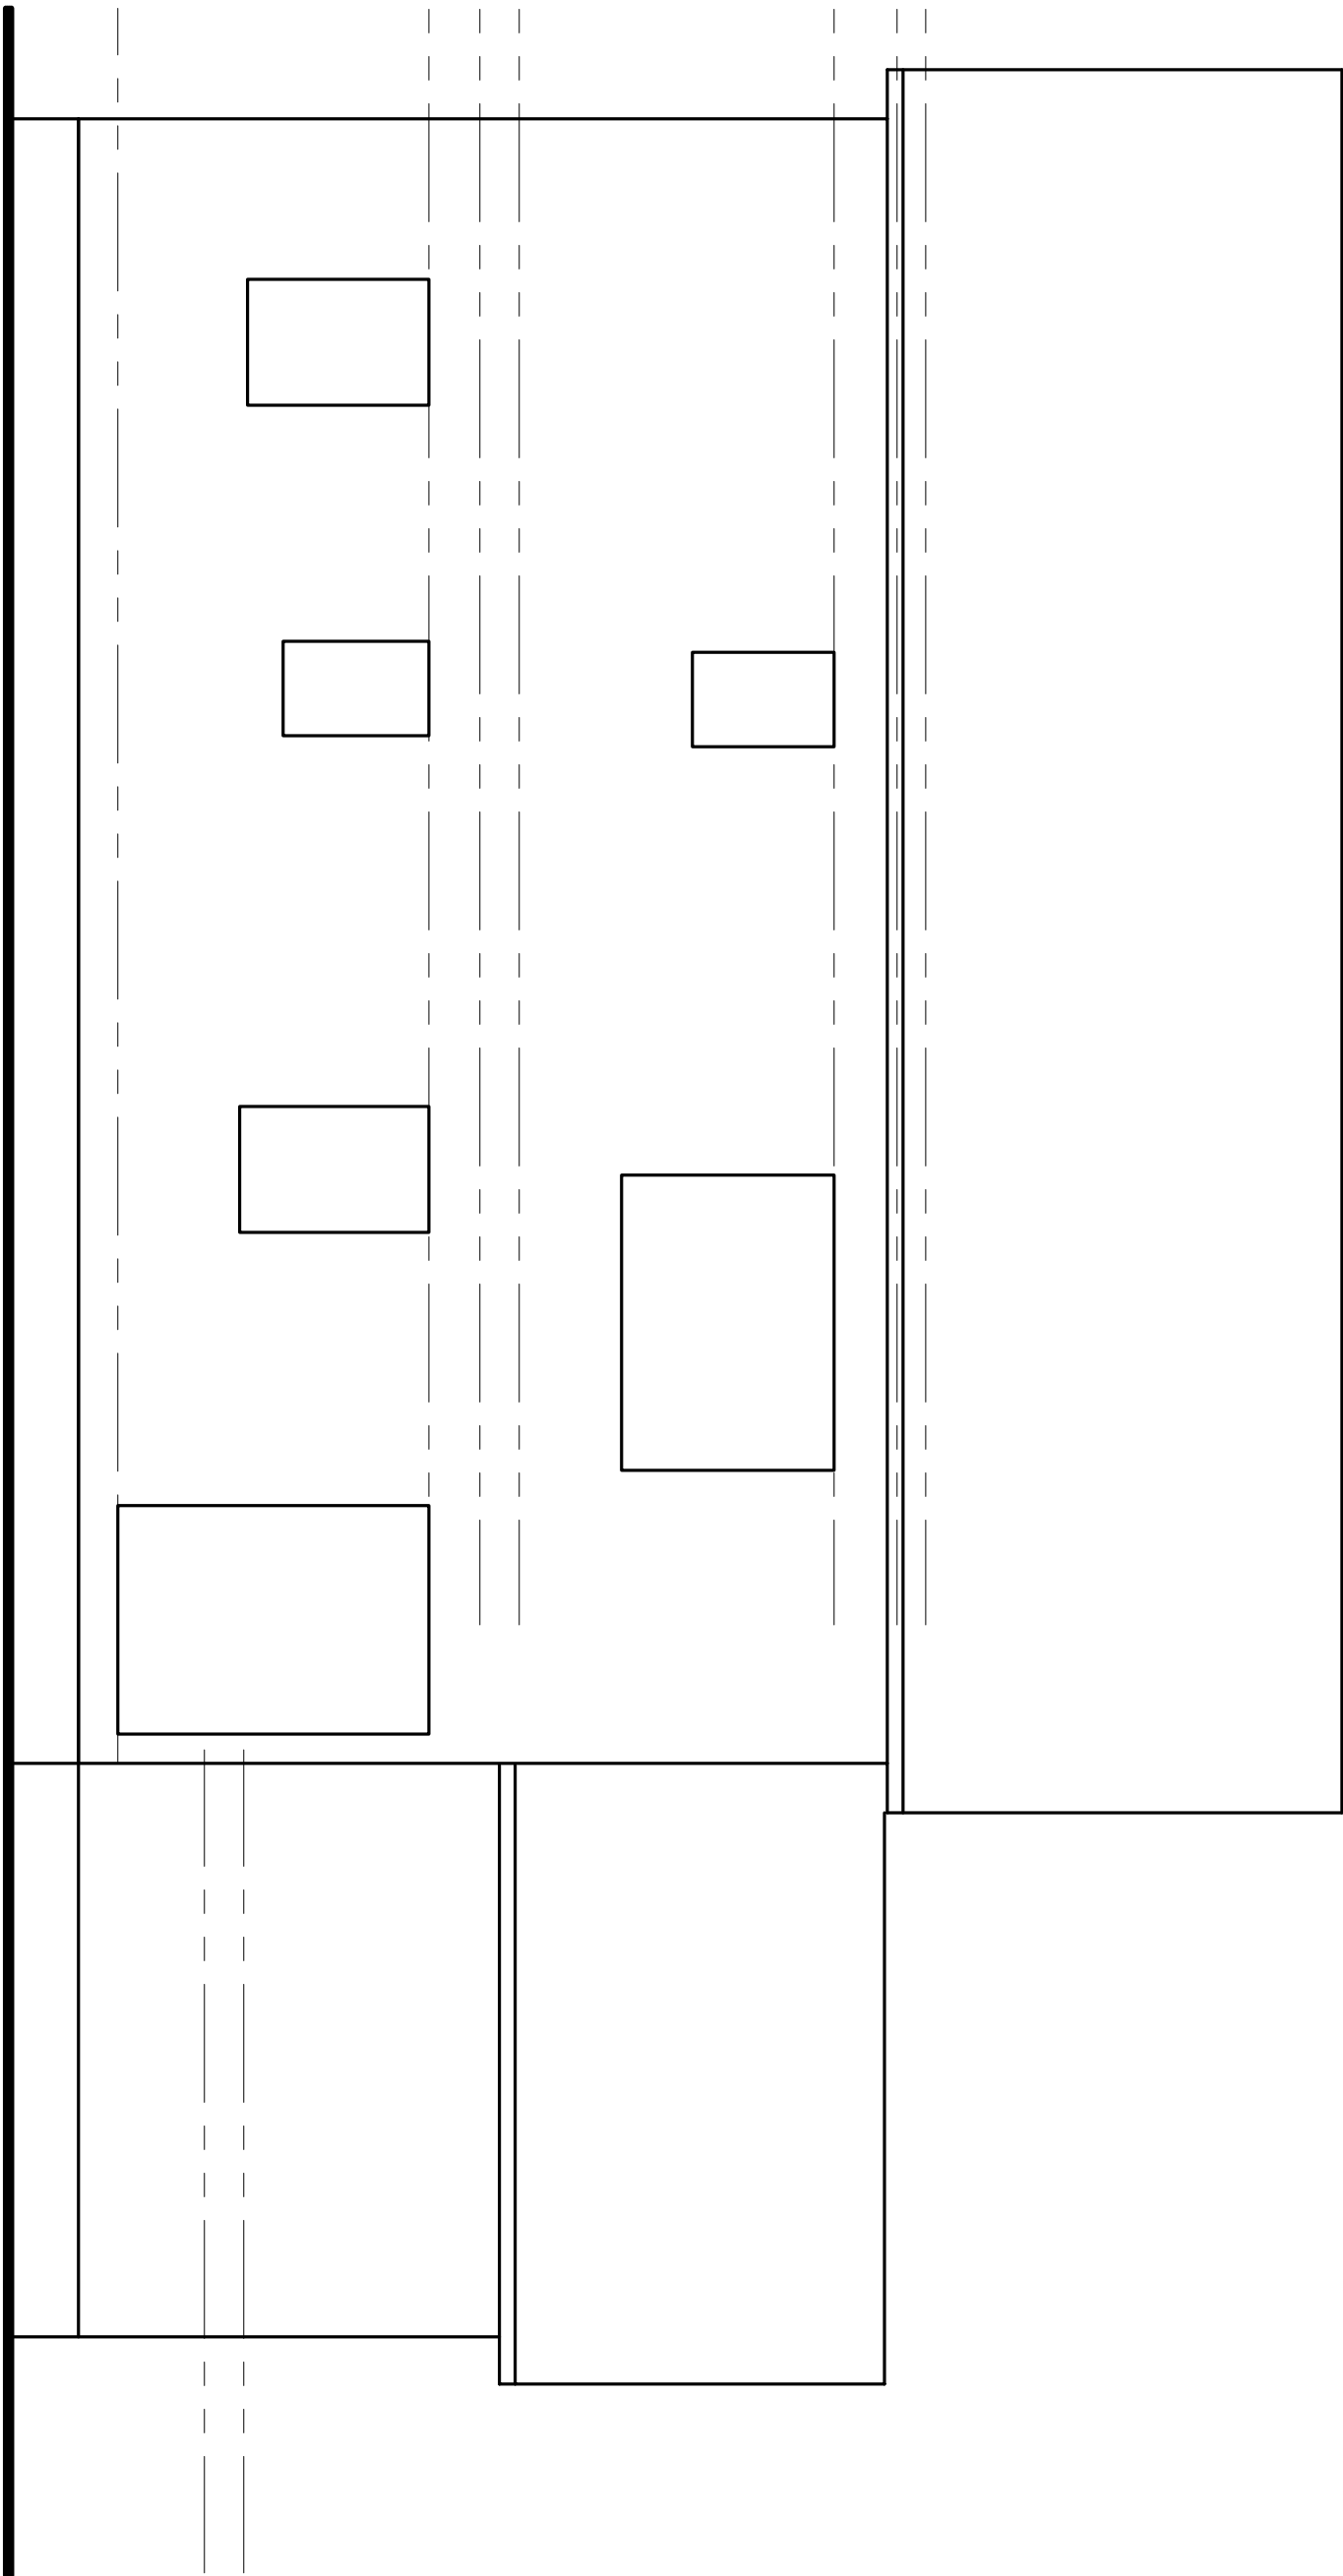

REAR ELEVATION
SCALE: 1/4" = 1'-0"

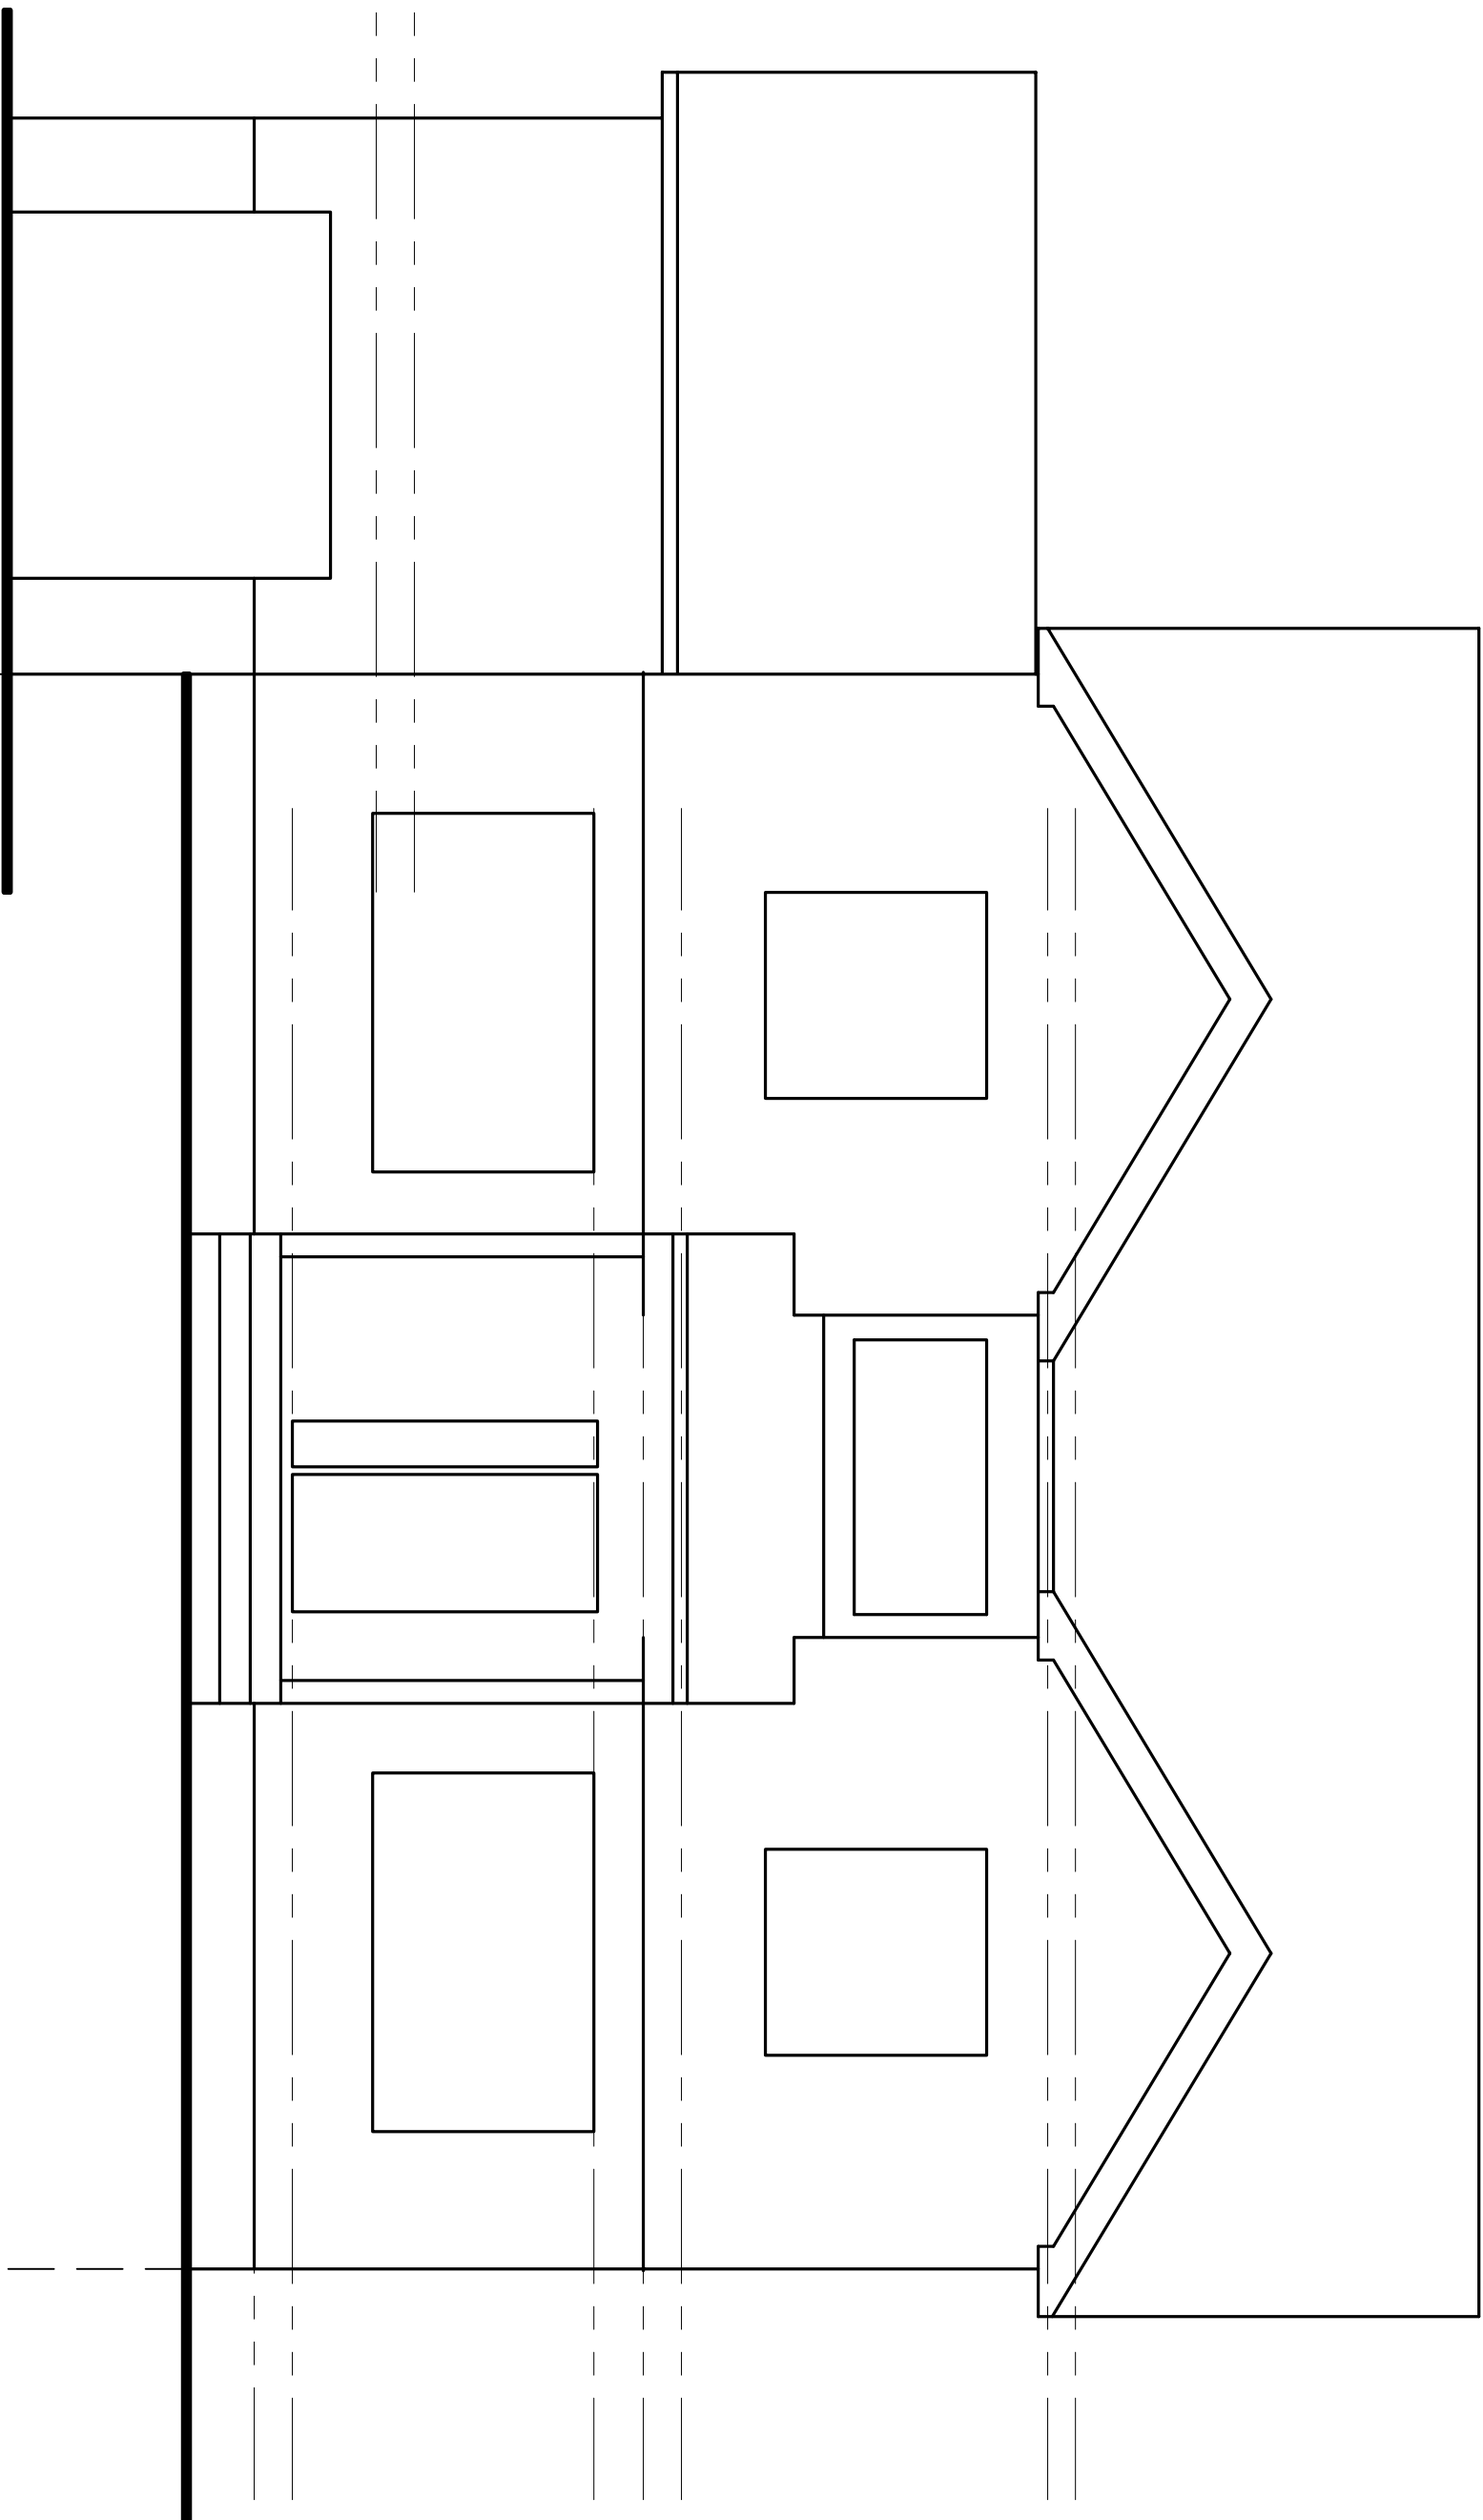

FRONT ELEVATION
SCALE: 1/4" = 1'-0"

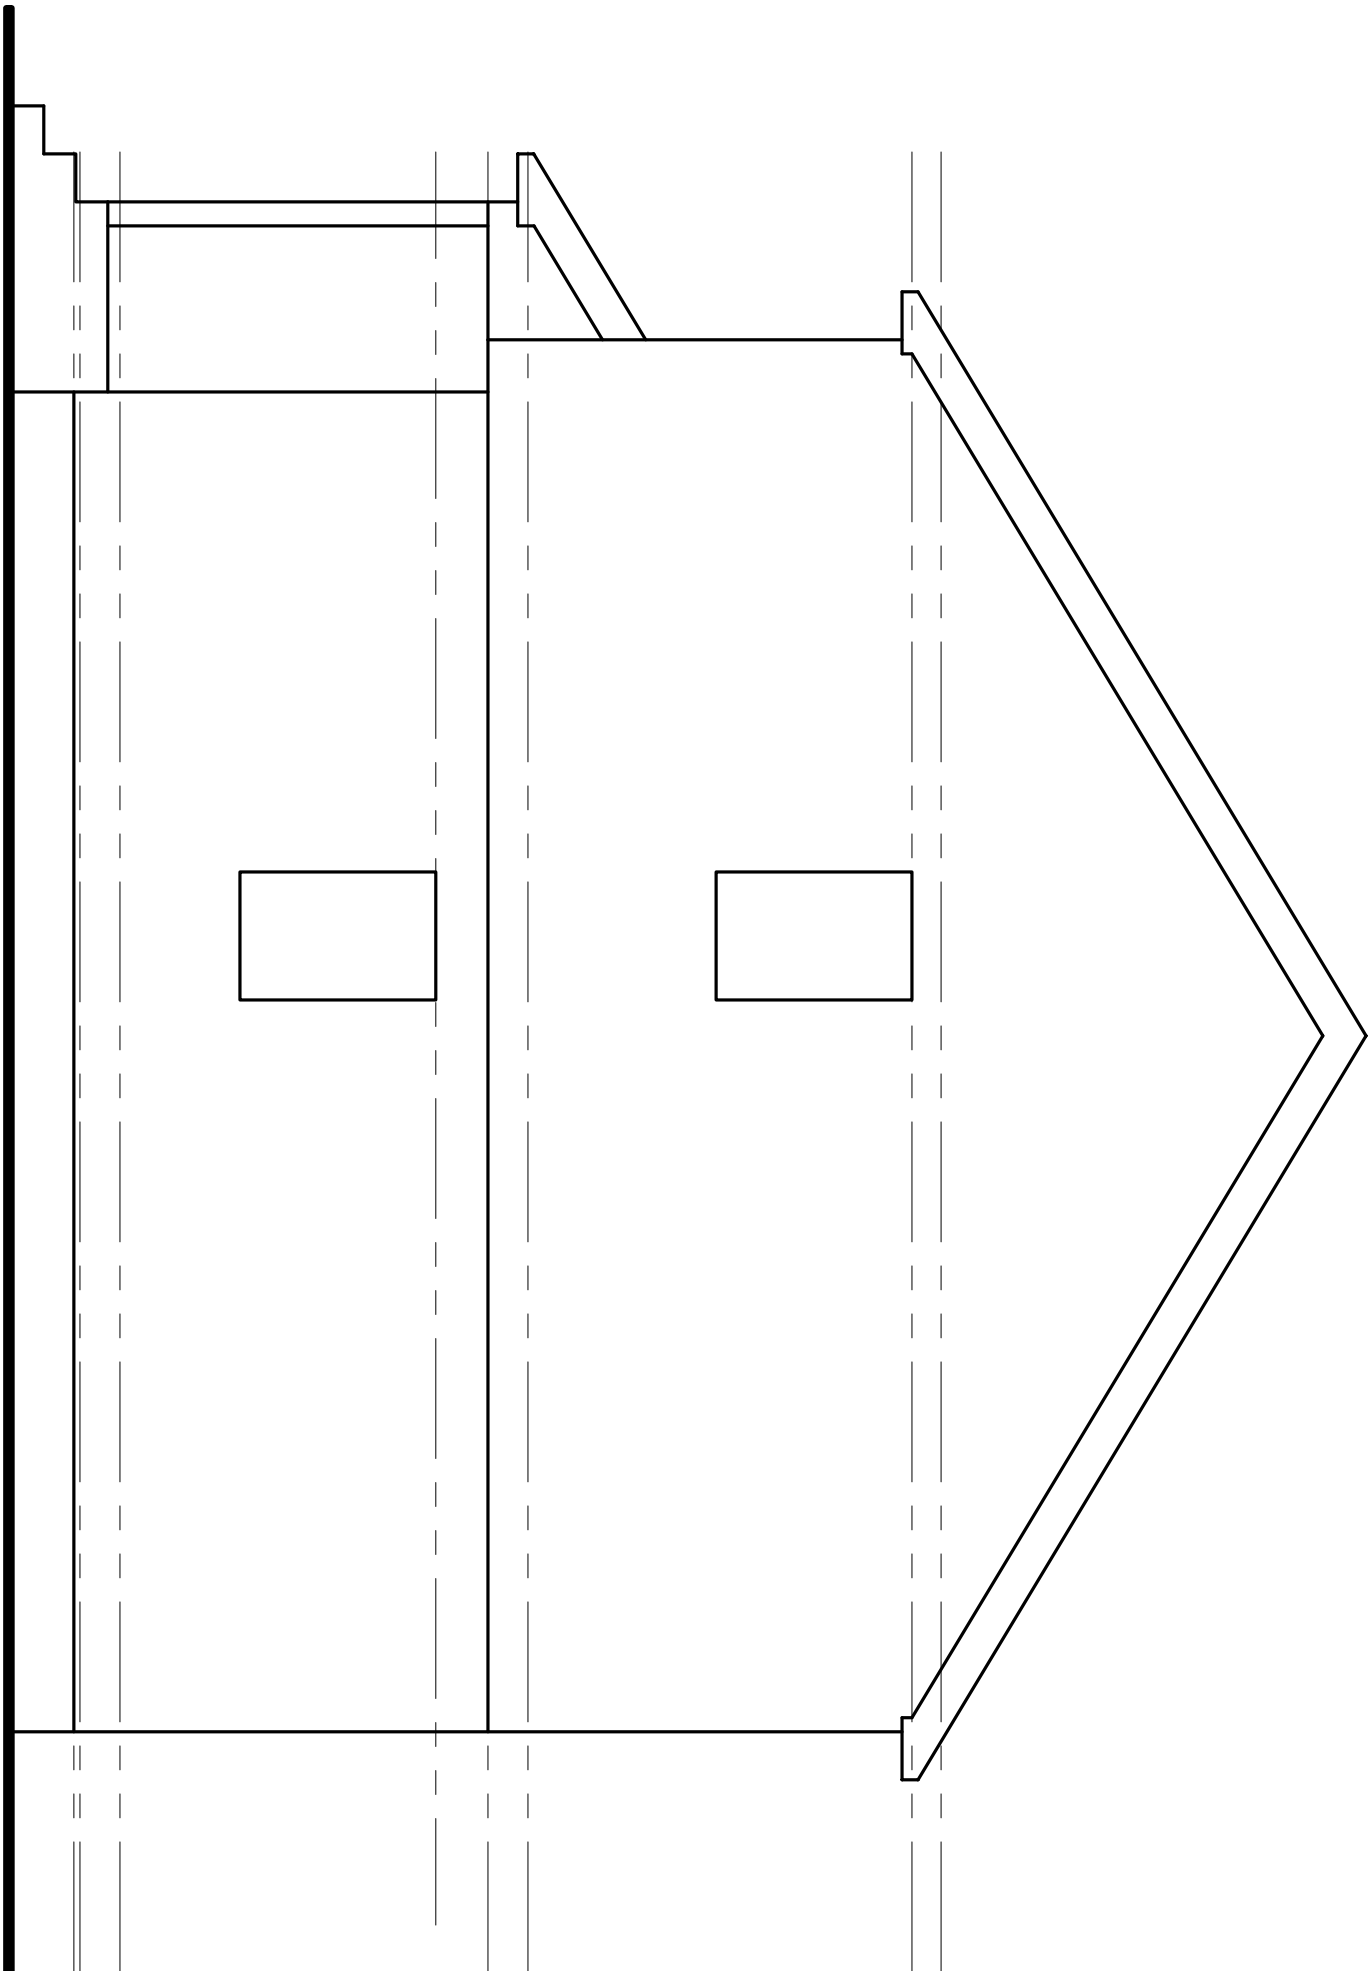

RIGHT ELEVATION
SCALE: 1/4" = 1'-0"

ALL DRAWINGS AND WRITTEN MATERIALS APPEARING HEREON ARE THE PROPERTY OF WELTZ | MOLINARI ARCHITECTURE. NO PART OF THIS DRAWING OR ANY INFORMATION CONTAINED HEREIN MAY BE REPRODUCED OR TRANSMITTED IN ANY FORM OR BY ANY MEANS, ELECTRONIC OR MECHANICAL, INCLUDING PHOTOCOPYING, RECORDING, OR BY ANY INFORMATION STORAGE AND RETRIEVAL SYSTEM, WITHOUT PERMISSION IN WRITING FROM WELTZ | MOLINARI ARCHITECTURE. ANY REUSE OR REVISION OF THIS DRAWING FOR THE PURPOSE OF CREATING THIS WORK OR REVISING SAID DRAWING SHALL BE CONSIDERED A VIOLATION OF THE PROFESSIONAL ETHICS AND A THEFT OF COMPANY ASSETS, BOTH OF WHICH SHALL BE PERSECUTED TO THE FULLEST EXTENT OF CURRENT STATUTES.

PROPOSED ALTERATIONS / ADDITION FOR:

MR. & MRS. KOLLANDER

1102 KORFITSSEN ROAD
NEW MILFORD, NEW JERSEY

LOT: 3
BLOCK: 205

AS-BUILT ELEVATIONS

COMMA NO: 20022

DRAWN BY: JLM CHECKED BY: JAM


REVISED:

ISSUED FOR
ZONING BOARD

DATE: 05.12.21


DRAWING NO:

AB2.01

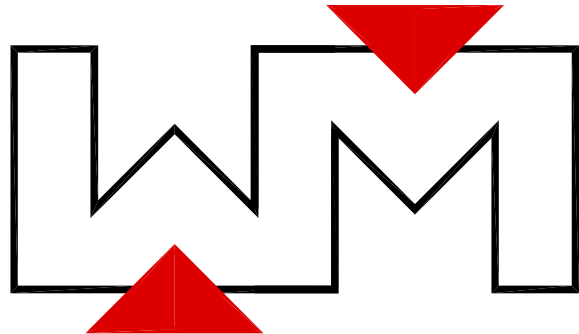


weltz | molinari
ARCHITECTURE

128 Broad St., 2nd Fl., Suite B, Red Bank, NJ 07701
t. 732.889.8000
email: info@wm-arch.com

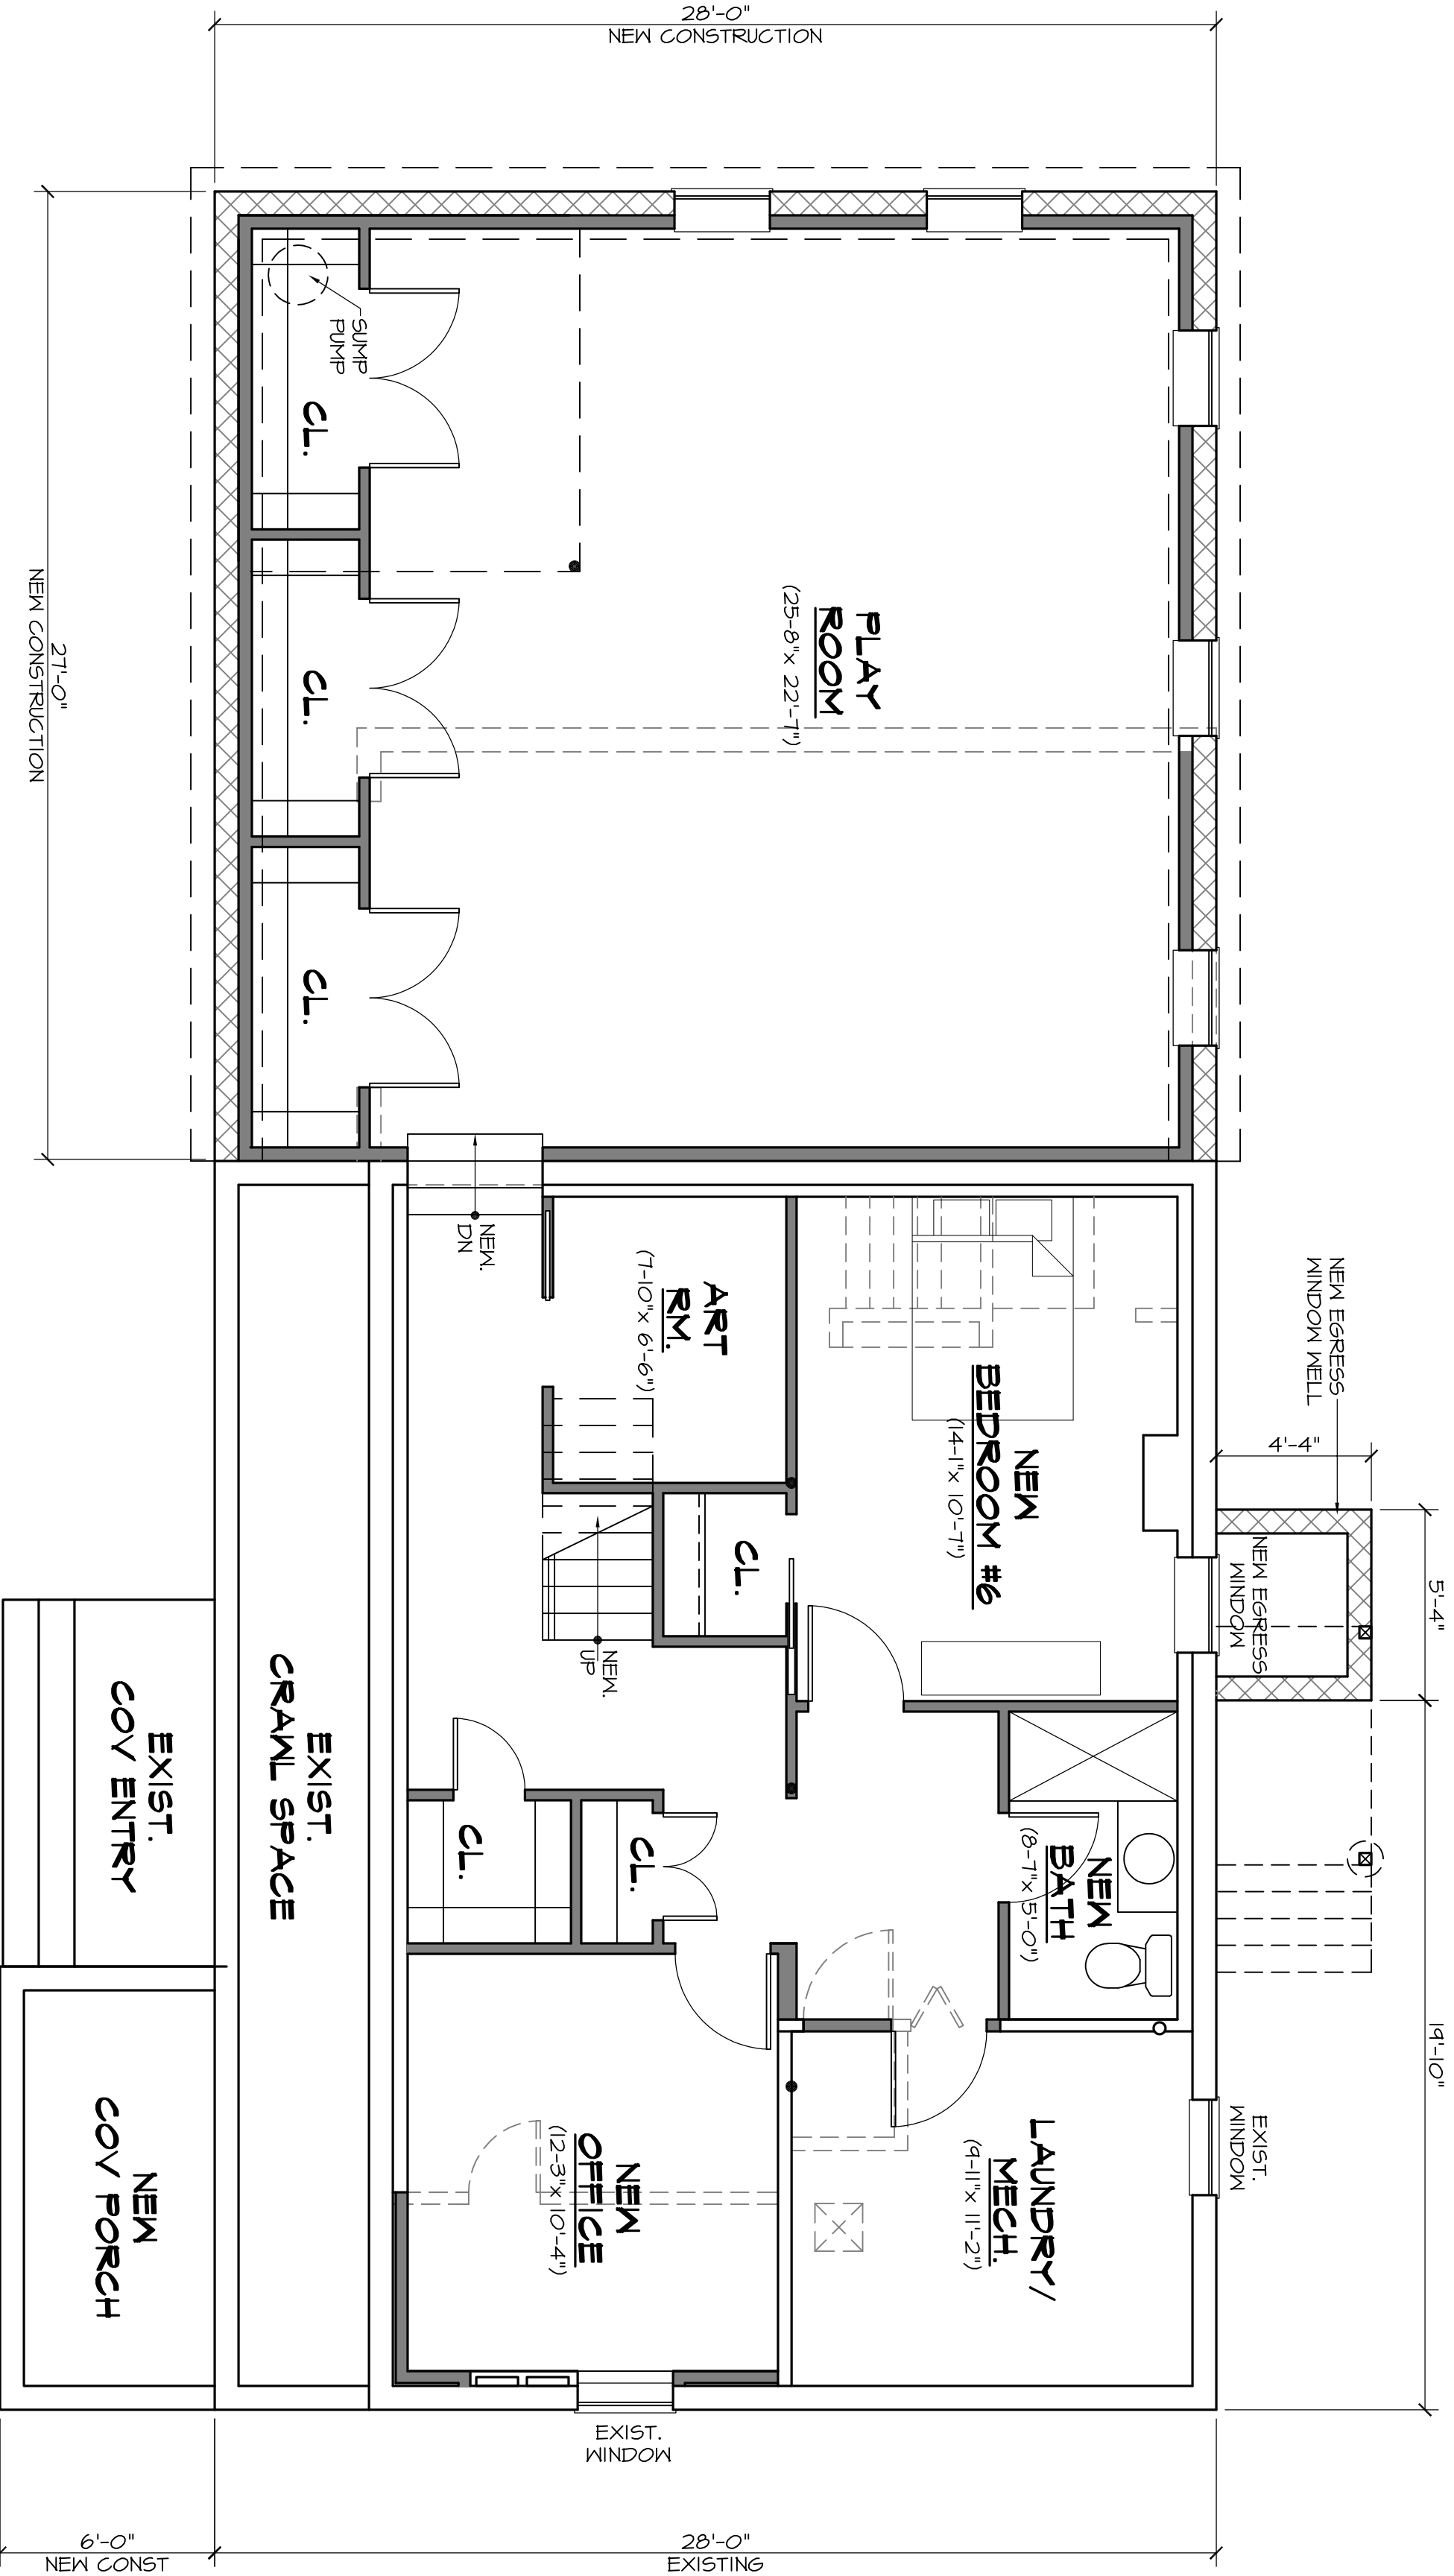

BASEMENT FLOOR PLAN
SCALE: 1/4" = 1'-0"


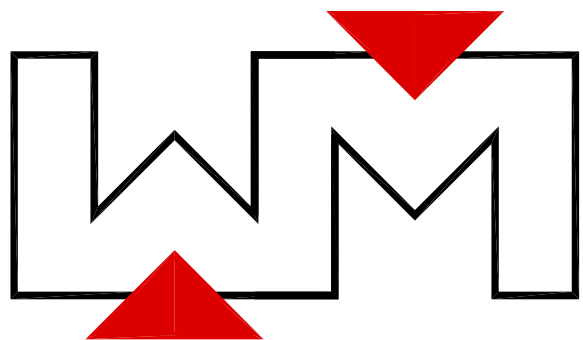


weltz | molinari
ARCHITECTURE
128 Broad St., 2nd Fl., Suite B, Red Bank, NJ 07701
t. 732.889.8000
email: info@wm-arch.com

PROPOSED ALTERATIONS / ADDITION FOR:		LOT: 3 BLOCK: 205
MR. & MRS. KOLLANDER		
1102 KORFITSSEN ROAD NEW MILFORD, NEW JERSEY		
PROPOSED FINISHED BASEMENT PLAN		




COMM. NO.	20022
DRAWN BY:	LLM
CHECKED BY:	JAM
DATE:	05.12.21
DRAWING NO.:	A1.01

ALL DRAWINGS AND WRITTEN MATERIALS APPEARING HEREON ARE THE PROPERTY OF WELTZ | MOLINARI ARCHITECTURE. NO PART OF THIS DRAWING OR ANY INFORMATION CONTAINED HEREIN MAY BE REPRODUCED OR TRANSMITTED IN ANY FORM OR BY ANY MEANS, ELECTRONIC OR MECHANICAL, INCLUDING PHOTOCOPYING, RECORDING, OR BY ANY INFORMATION STORAGE AND RETRIEVAL SYSTEM, WITHOUT PERMISSION IN WRITING FROM WELTZ | MOLINARI ARCHITECTURE. ANY REUSE OR REVISION OF THIS DRAWING FOR THE PURPOSE OF CREATING THIS WORK OR REVISING SAID DRAWING SHALL BE CONSIDERED A VIOLATION OF THE ARCHITECTURAL AGREEMENT, WHICH SHALL BE PERSECUTED TO THE FULLEST EXTENT OF CURRENT STATUTES.

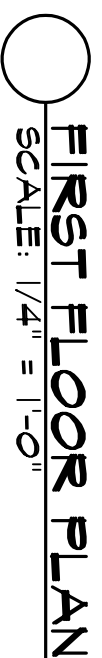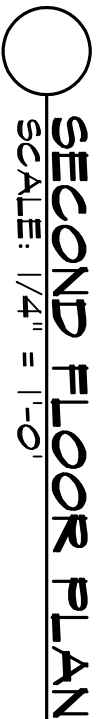

COMM NO:	20022	
DRAWN BY:	JLN	CHECKED BY:
		JAM
REVISED:		

ALL DRAMAS AND WRITTEN MATERIALS APPEARING HEREIN CONSTITUTE ORIGINAL AND UNPUBLISHED WORK OF IM ARCHITECTURE. THE REPRODUCTION OF THIS DRAWING FOR THE PURPOSE OF COPYING THIS WORK OR REVENISING SAID DRAWING SHALL BE CONSIDERED A VIOLATION OF BOTH THE PROFESSIONAL CODE OF ETHICS AND A THEFT OF COMPANY ASSETS BOTH OF WHICH SHALL BE PERSSECUTED TO THE FULLEST EXTENT OF CURRENT STATUTES.

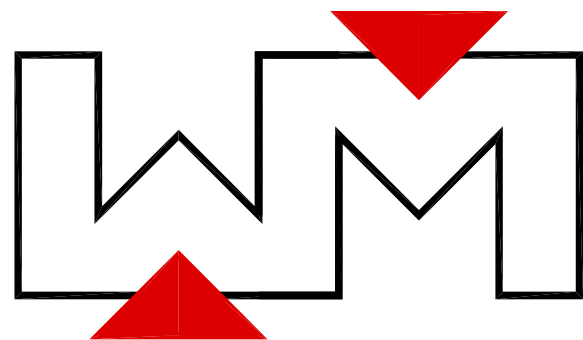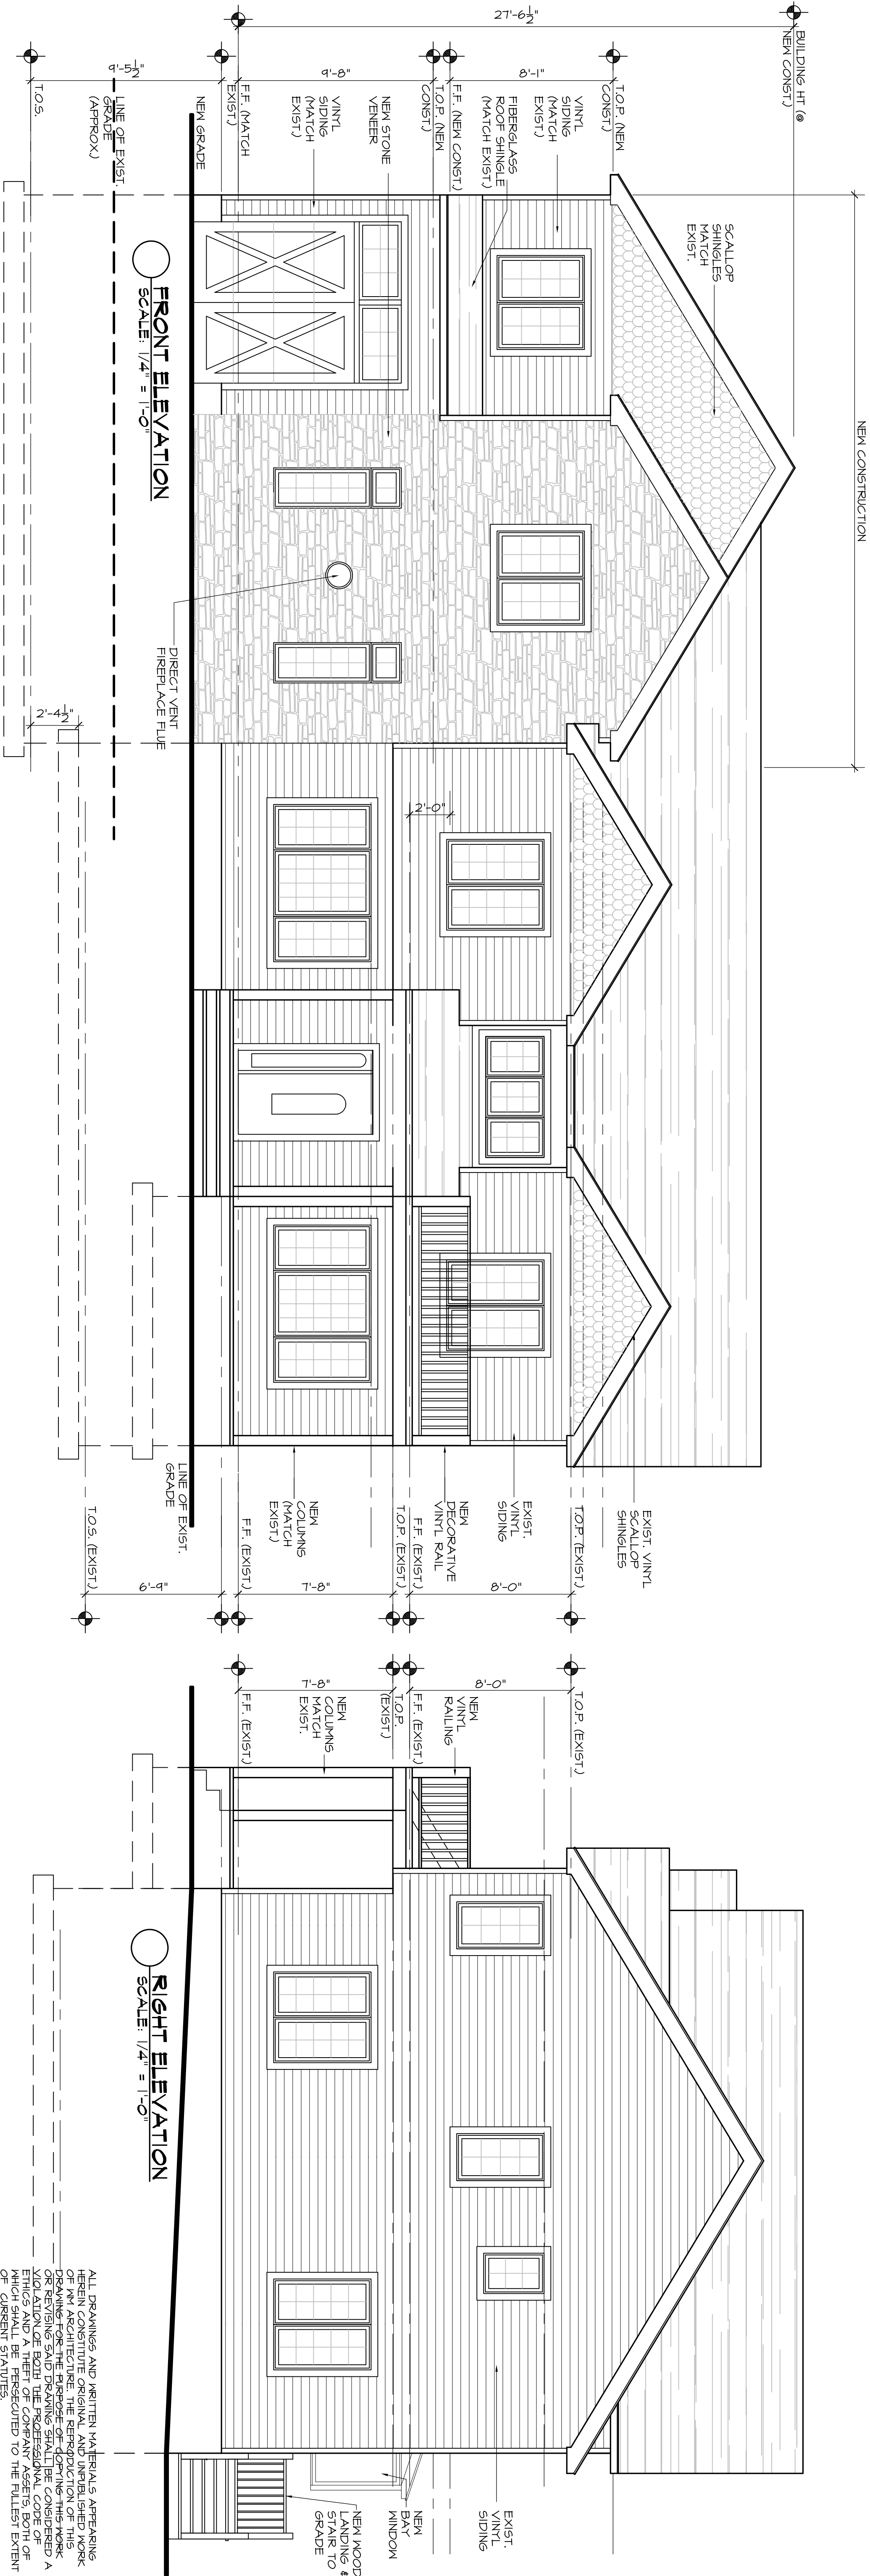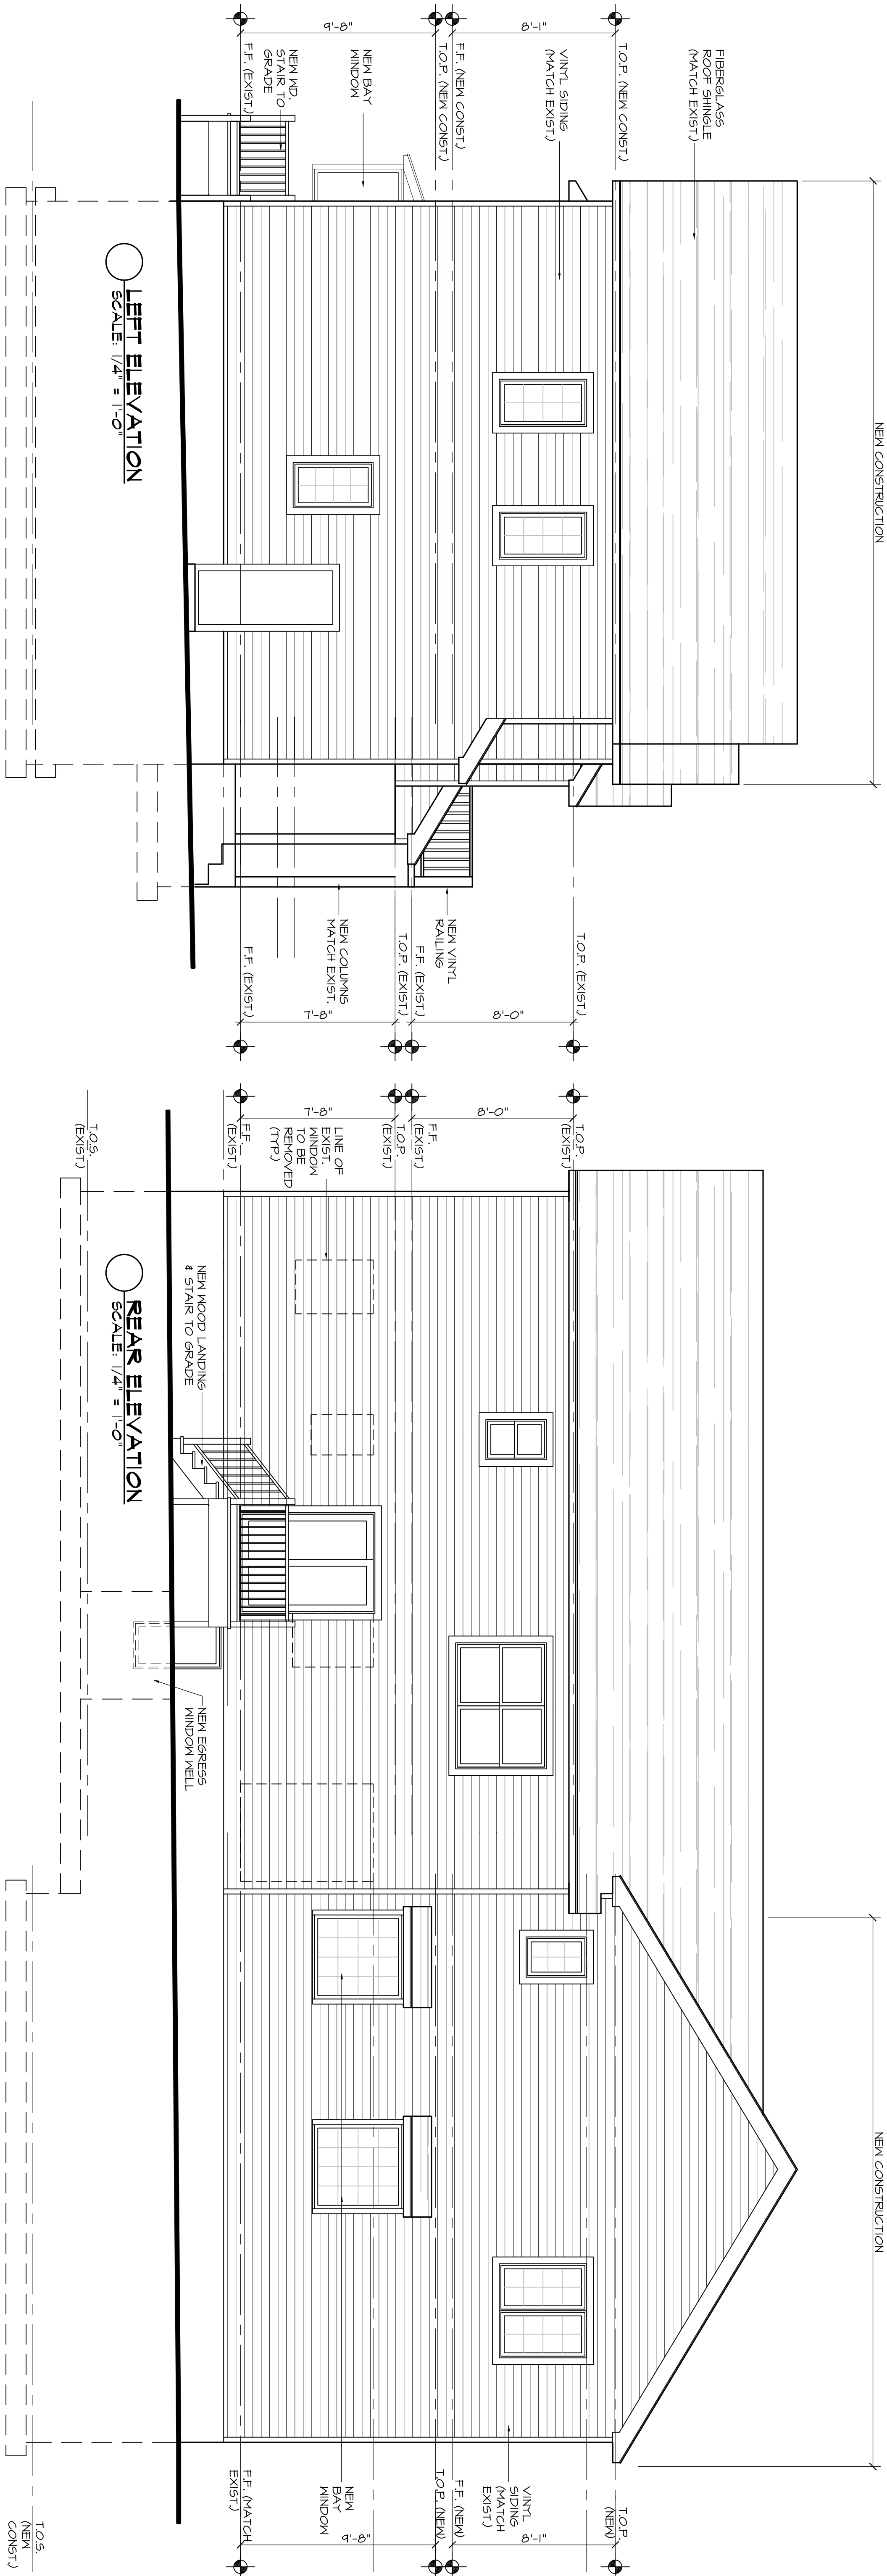

weltz | molinari
ARCHITECTURE
128 Broad St., 2nd Fl., Suite B, Red Bank, NJ 07701
t. 732.889.8000
email: info@wm-arch.com

PROPOSED ALTERATIONS / ADDITION FOR:
MR. & MRS. KOLLANDER

1102 KORFITSSEN ROAD
NEW MILFORD, NEW JERSEY

LOT: 3
BLOCK: 205

PROPOSED ELEVATIONS

COMM. NO.: 20022
DRAWN BY: JLM
CHECKED BY: JAM
REVISED:

ISSUED FOR
ZONING BOARD

DATE: 05.12.21

DRAWING NO:

A2.01

ALL DRAWINGS AND WRITTEN MATERIALS APPEARING
HEREIN ARE THE PROPERTY OF WELTZ | MOLINARI
ARCHITECTURE. NO REPRODUCTION OF THIS
DRAWING FOR THE PURPOSE OF COPYING THIS WORK
OR REVISING SAID DRAWING SHALL BE CONSIDERED A
VIOLATION OF THE ARCHITECTURAL ETHICS AND A
BREACH OF THE ARCHITECT'S DUTY OF CARE, BOTH OF
WHICH SHALL BE PERSECUTED TO THE FULLEST EXTENT
OF CURRENT STATUTES.